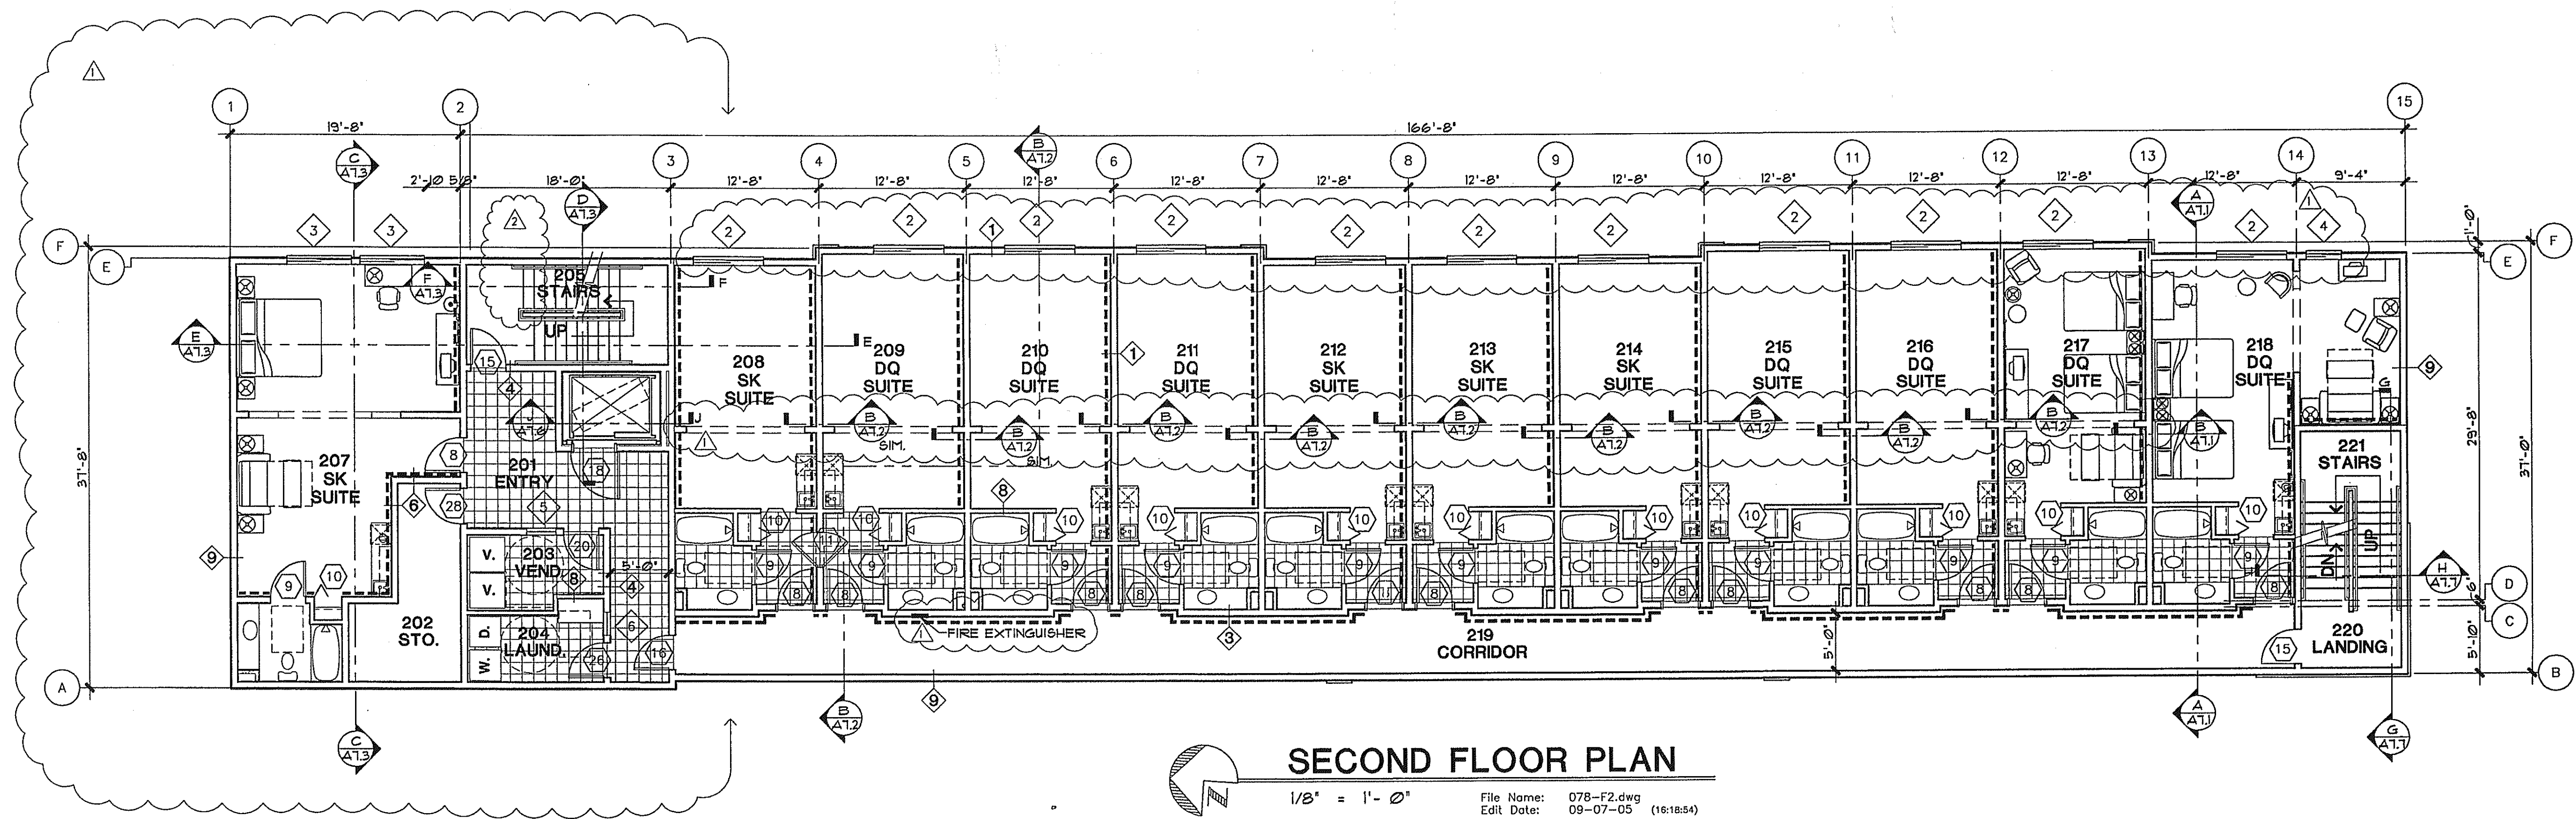



SECOND FLOOR PLAN

1/8" = 1'-0"

File Name: 078-F2.dwg
Edit Date: 09-07-05 (16:18:54)

REVISIONS	BY
02-25-05 PLAN CHECK REV.	gde
03-15-05 PLAN CHECK REV.	gde

Design Resources
Architects
104 LaPointe Street
TEL 208-343-5511
WEB www.dsrresources.com
Boise, Idaho 83705
FAX 208-343-5555

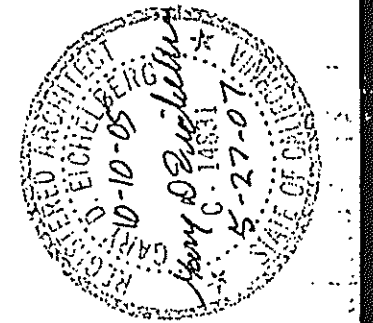

OWNER
J.P. PATEL
BEST WESTERN COLONADE
3600 ELCAMINO REAL
ATASCADERO, CA 93422

HOLIDAY INN EXPRESS
HOTEL & SUITES
ANNEX ADDITION
IN
PASO ROBLES, CALIFORNIA

DRAWN
GDE
CHECKED
ROC
DATE
OCTOBER 14, 2004
SCALE
AS NOTED
JOB NO.
03-DRL-101
SHEET

A1.2

OF SHEETS

File Name: X079-A12.dwg
Edit Date: 10-07-05 (10:52:11)
NOV 02 2005