



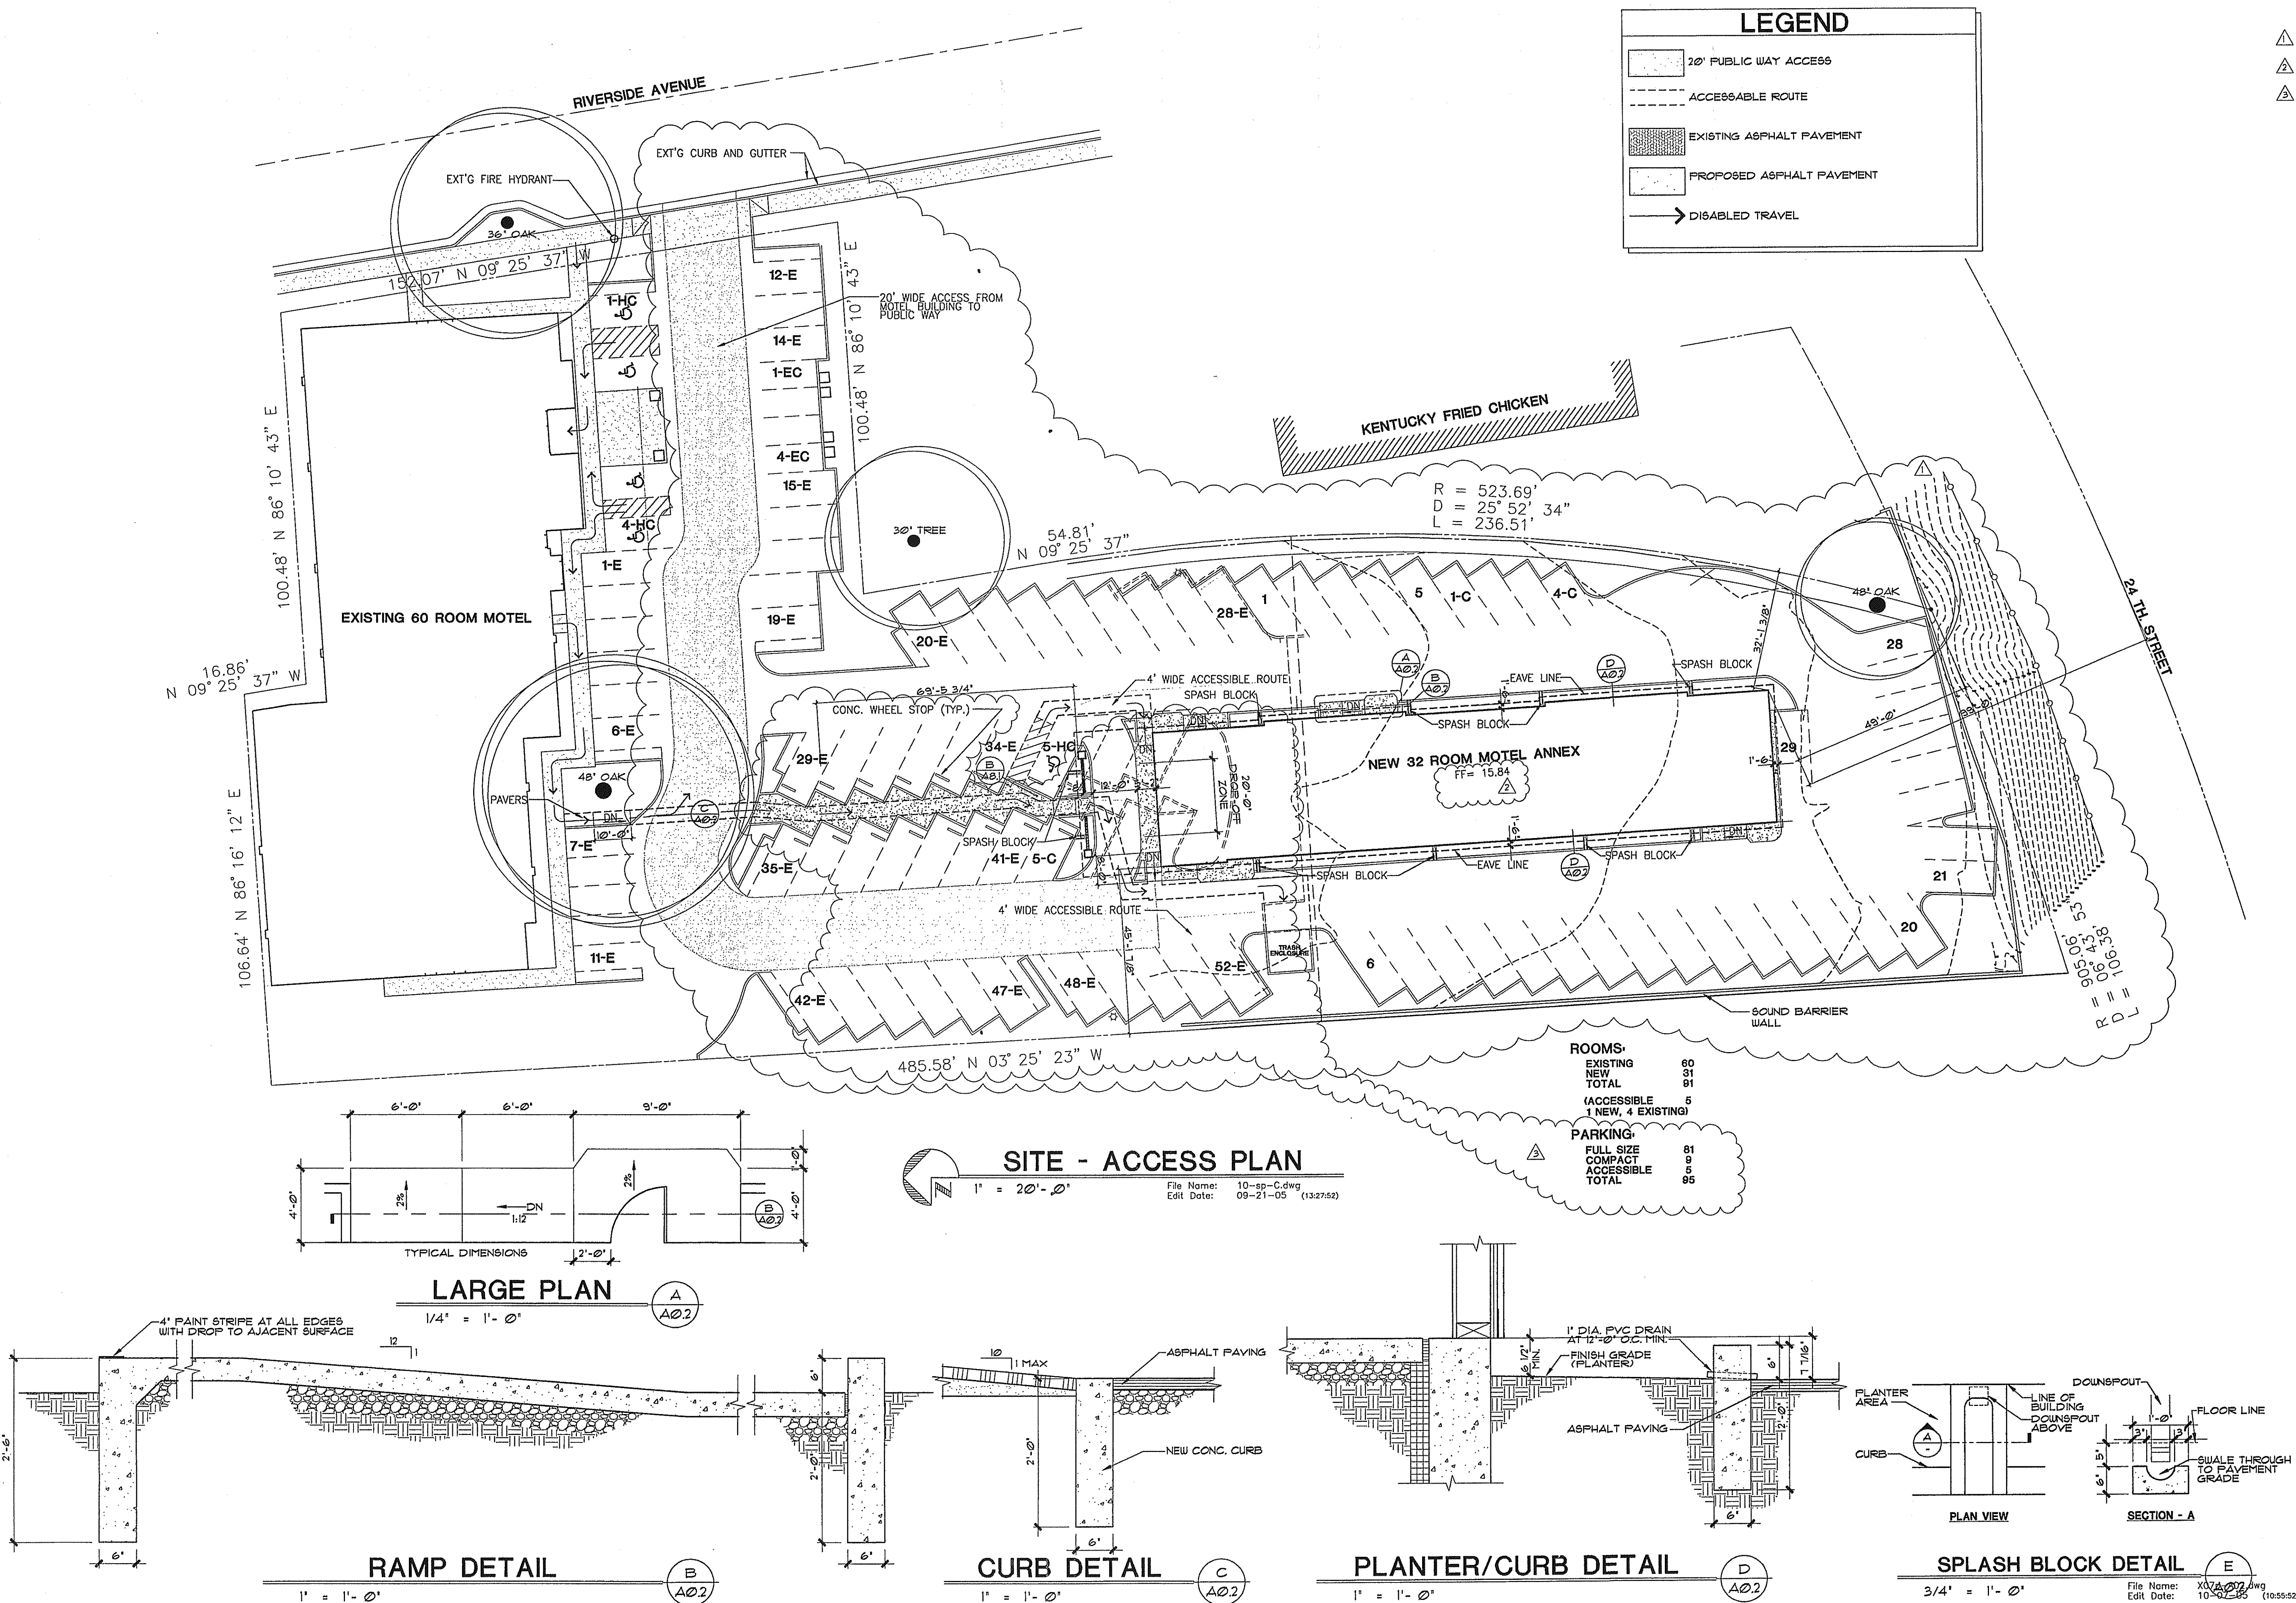

REVISIONS	BY
02-25-05 NEW SHEET	gde
06-24-05 PLAN CHECK RESR.	gde
09-15-05 PLAN CHECK RESR.	gde

Arizona
 California
 Idaho, Nevada
 Oregon
 Wyoming
Design Resources
 Architects

1014 Laporte Street
 BOISE, IDAHO 83706
 TEL: 208-343-5511
 FAX: 208-343-5568
 WEB: www.designresources.com

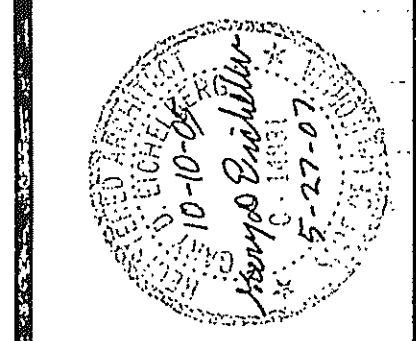

OWNER
 J.P. PATEL
 BEST WESTERN COLONADE
 3800 ELCAMINO REAL
 ATASCADERO, CA 93422

HOLIDAY INN EXPRESS
 HOTEL & SUITES
 ANNEX ADDITION
 IN
PASO ROBLES, CALIFORNIA

DRAWN: GDE
 CHECKED: ROC
 DATE: OCTOBER 14, 2004
 SCALE: AS NOTED
 JOB NO.: 03-DRL-101
 SHEET: **A0.2**
 OF SHEETS

RECEIVED
 NOV 02 2005